




DIST	COUNTY	ROUTE	KILOMETER TOTAL PROJECT	POST PROJECT	SHEET No	TOTAL SHEETS
04	SF, Alameda	80	12.2/14.3 0.0/4.0	407a 09S16	1204	

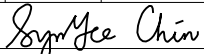

03/08/10

REGISTERED ELECTRICAL ENGINEER DATE

05-06-2010

PLANS APPROVAL DATE

PB AMERICAS, Inc.
A Parsons Brinckerhoff Company
303 Second St., Suite 700N
San Francisco, CA 94107-1317

The State of California or its officers or agents shall not be responsible for the accuracy or completeness of electronic copies of this plan sheet.

Caltrans now has a web site To get to the web site, go to <http://www.dot.ca.gov>

REGISTERED PROFESSIONAL ENGINEER


SYN YEE CHIN

No. 18186

Exp. 09/30/2011


ELECTRICAL

STATE OF CALIFORNIA

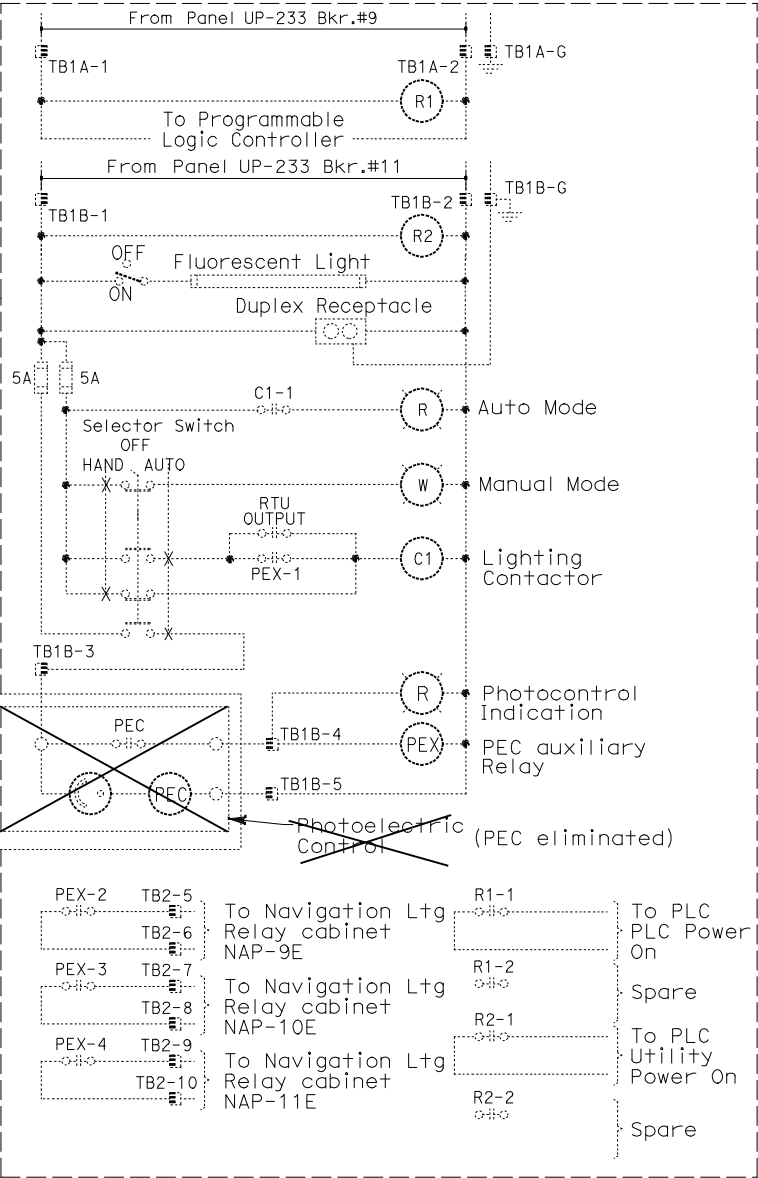

NOTES:

- This plan sheet is a record drawing of the Skyway Structures Remote Terminal Unit No. 12E. The Contractor shall verify the existing installation. See sheet EE-356 from the Skyway Structures, contract No. 04-012024.
- References:
Refer to Sheet E-908.

REQUEST FOR INFORMATION NOT ADDRESSED IN THIS CCO REMAIN IN FORCE						
	03/08/10	MEP INTEGRATION	JE	FW	110	
MARK	DATE	DESCRIPTIONS	BY	CH'D	CCO#	
REVISIONS						


CONTRACT CHANGE ORDER NO. _____
SHEET ____ OF ____

DETAILS
SCADA REMOTE TERMINAL UNIT SYSTEM
RTU #12E ELEMENTARY DIAGRAM
NO SCALE

E-909A

THIS PLAN ACCURATE FOR ELECTRICAL WORK ONLY.

FOR REDUCED PLANS ORIGINAL
SCALE IS IN MILLIMETERS

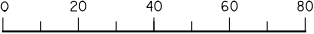

DGN FILE =>04-0120f1_E-909A.dgn
USERNAME =>llorico

CU 04251

EA 0120F1